

GEORGE BEGGS TRUST
306 West 7th Street, Suite 644
Fort Worth, Texas 76102

April 11, 2018

Mayor & City Council
City of Fort Worth
1000 Throckmorton
Fort Worth, Texas 76102

Mayor & City Council
City of Willow Park
516 Ranch House Road
Fort Worth, Texas 76087

Re: Proposed ETJ Agreement between City of Fort Worth & City of Willow Park


Mayors & Councils:

This letter is to advise you the George Beggs Trust has reviewed the proposed ETJ Agreement line indicated on the Conceptual Plan dated April 10, 2018 prepared by Jacob Martin Engineers. This Agreement, as proposed, would transfer a small portion (noted in green on the Conceptual Plan) of the trust property from the Fort Worth ETJ to the Willow Park ETJ.


We believe the resolution of the ETJ boundary between the two cities is beneficial to the future development potential of the trust property. The trust supports the proposed ETJ boundary as indicated on the above referenced exhibit.

Sincerely,

GEORGE BEGGS TRUST

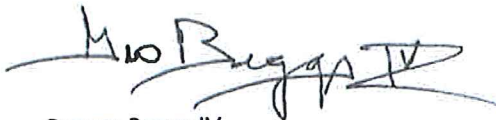A handwritten signature in black ink, appearing to read "George Beggs IV", with a stylized flourish at the end.

George Beggs IV
Co-Trustee

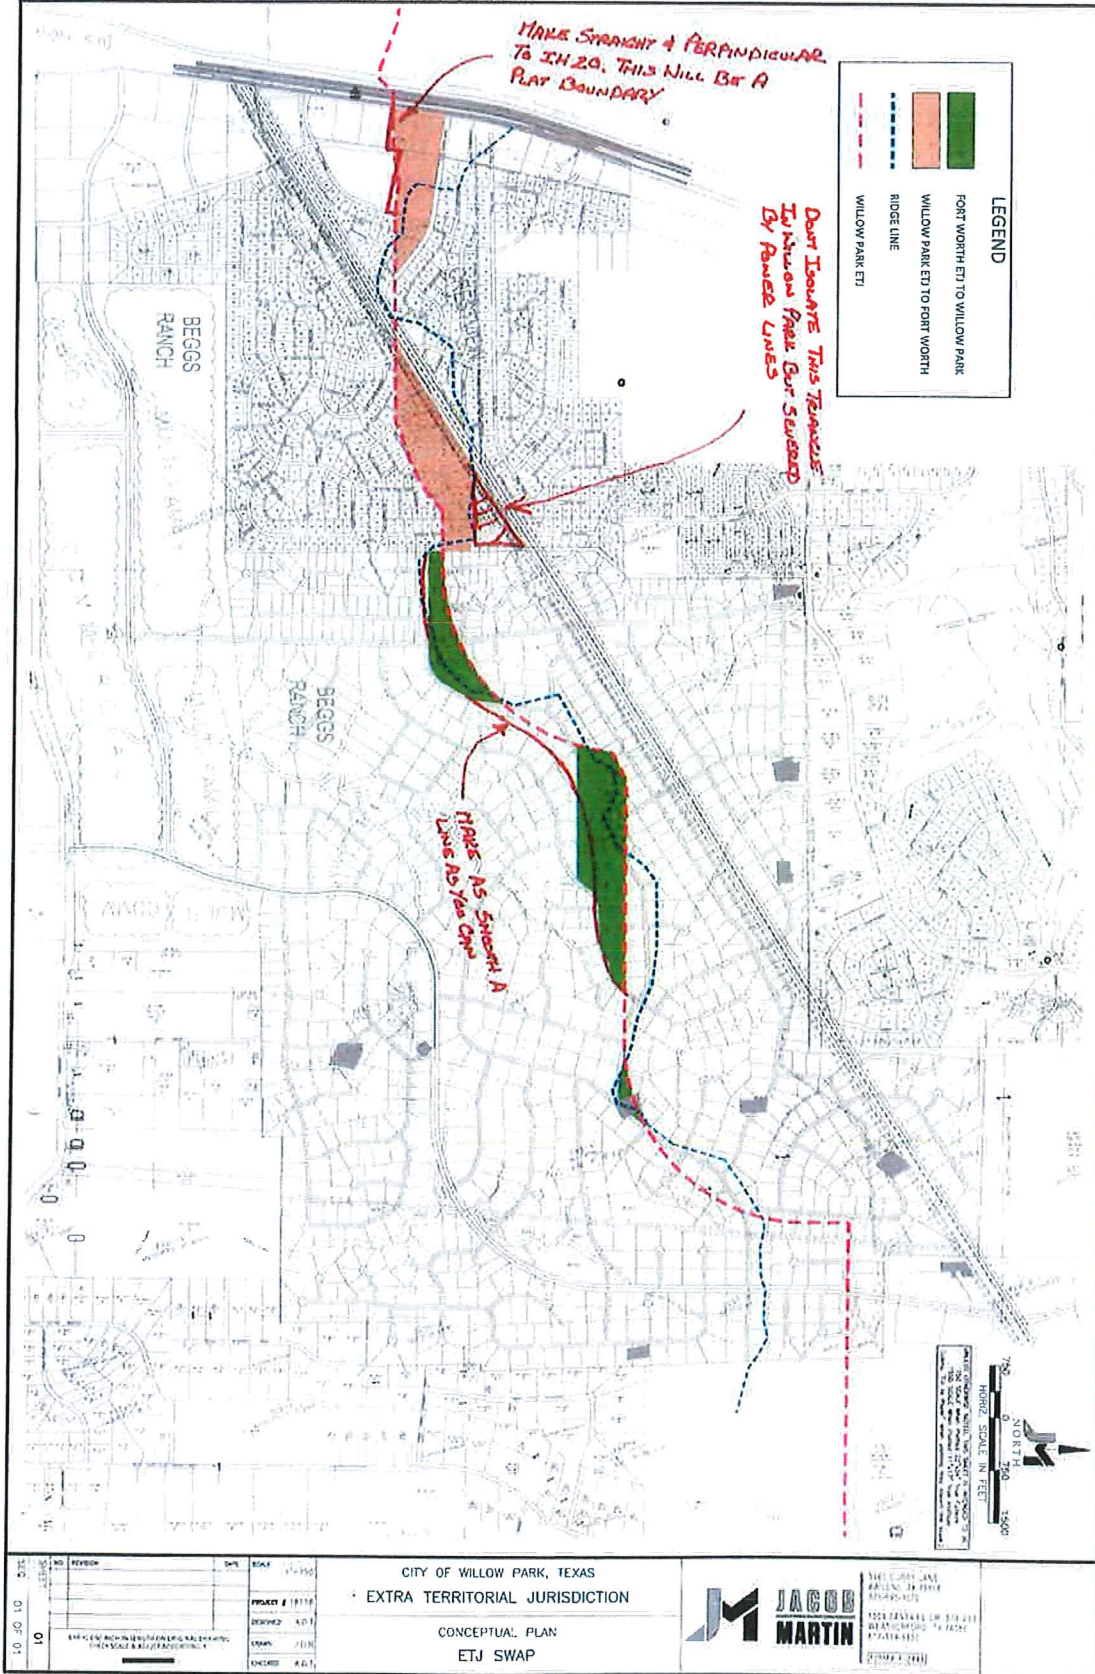

CITY OF WILLOW PARK, TEXAS EXTRA TERRITORIAL JURISDICTION		JACOB MARTIN 10000 WILLOW PARK, TEXAS 7500 WILLOW PARK, TEXAS 7500 WILLOW PARK, TEXAS
CONCEPTUAL PLAN ETJ SWAP		
SHEET NO. 01 OF 01	DATE: 11/22/2018 DRAWN: J.B. CHECKED: J.B.	10000 WILLOW PARK, TEXAS 7500 WILLOW PARK, TEXAS 7500 WILLOW PARK, TEXAS

BOSWELL INTERESTS, LTD.

1320 LAKE STREET
FORT WORTH, TEXAS 76120
Telephone: 817-338-4561

May 14, 2018

The Honorable Betsy Price, Mayor
The Fort Worth City Council
1000 Throckmorton
Fort Worth, Texas 76107

The Honorable Doyle Moss, Mayor
The Willow Park City Council
516 Ranch House Road
Willow Park, Texas 76087

Re: Proposed Location of Revised Extra Territorial Jurisdiction ("ETJ")
Boundaries Between Fort Worth and Willow Park

Honorable Mayors Price and Moss;
Honorable City Council Members:

This letter shall evidence Boswell Interests, Ltd.'s support for the location of the revised ETJ boundaries as between the cities of Fort Worth and Willow Park. Said revised ETJ boundaries are set forth on the map, attached hereto as Exhibit "A", denoting the proposed Conceptual Plan ETJ Swap, prepared by the firm of Jacob Martin and date stamped by Derek Thompson, Licensed Professional Engineer, on April 10, 2018.

Thank you for your efforts regarding this project. Please contact the undersigned should you have any questions concerning this matter.


Sincerely,

Boswell Interests, Ltd.

By: 
John P. Boswell

EXHIBIT "A"

PLOTTED ON: 4/10/2018 2:25 PM PRINTED BY: JEFF BURNS
 X:\C\WILLOW_PARK\18156 - FORT WORTH WHOLESALE WATER\DRAWINGS\PRELIMINARY\ETJ_SWAP\WP_ETJ_SWAP_EXHIBIT.DWG

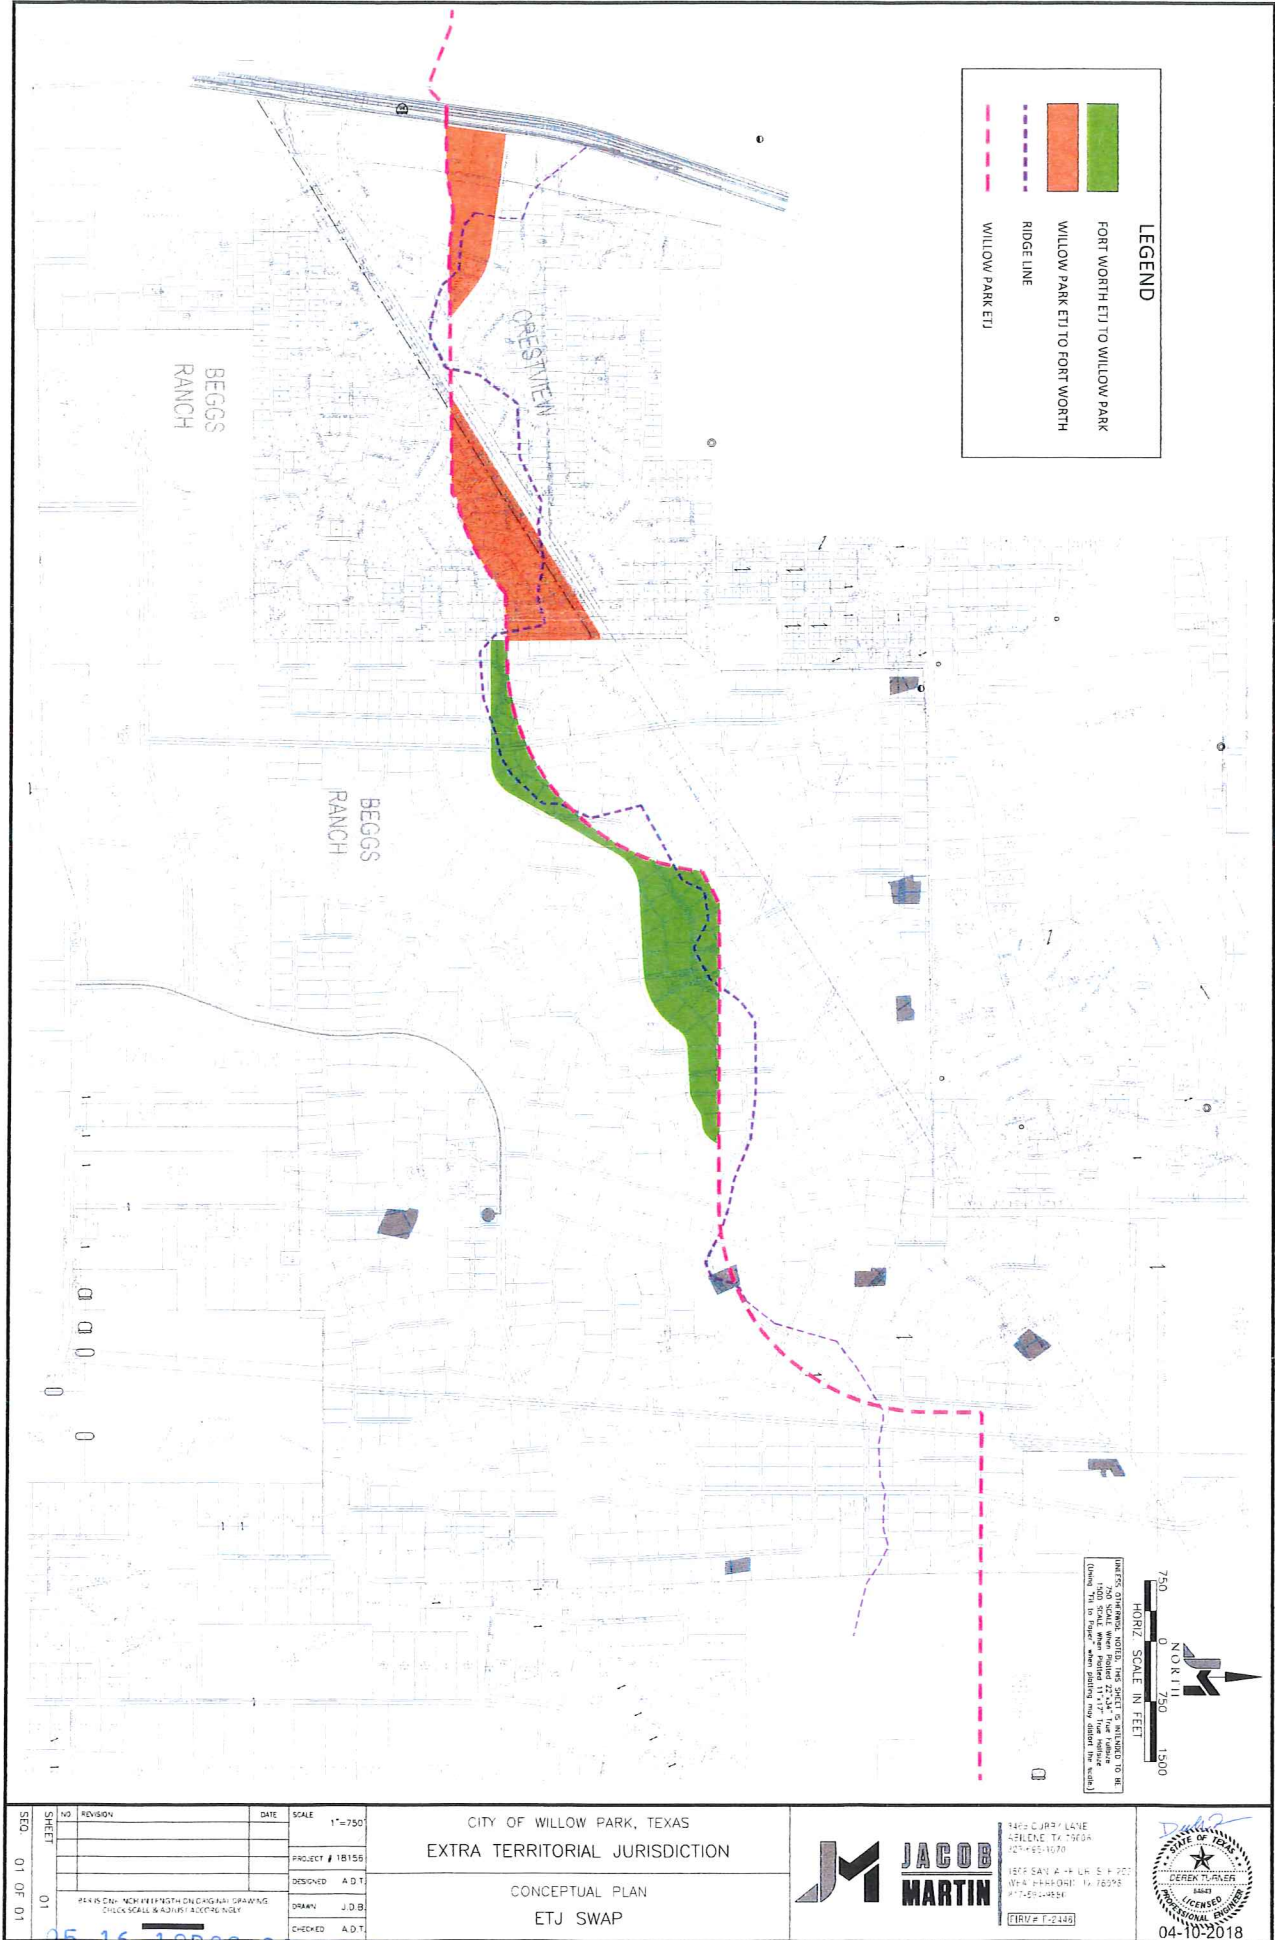

NO.	REVISION	DATE	SCALE
01			1"=750'
02			
03			
CITY OF WILLOW PARK, TEXAS
 EXTRA TERRITORIAL JURISDICTION

CONCEPTUAL PLAN
 ETJ SWAP



3400 C J P P L L N E
 ARLING, TX 76010
 817-455-1070
 1872 SAN A - 44 LK 5 - 4 2017
 1872 SAN A - 44 LK 5 - 4 2017
 1872 SAN A - 44 LK 5 - 4 2017
 1872 SAN A - 44 LK 5 - 4 2017



05 16 18P02:29 RCVD